


“F”

Pool Plan Set

Pott's Pool Con Regs UPX P23-00318
Planning Commission Hearing Date July 16, 2025

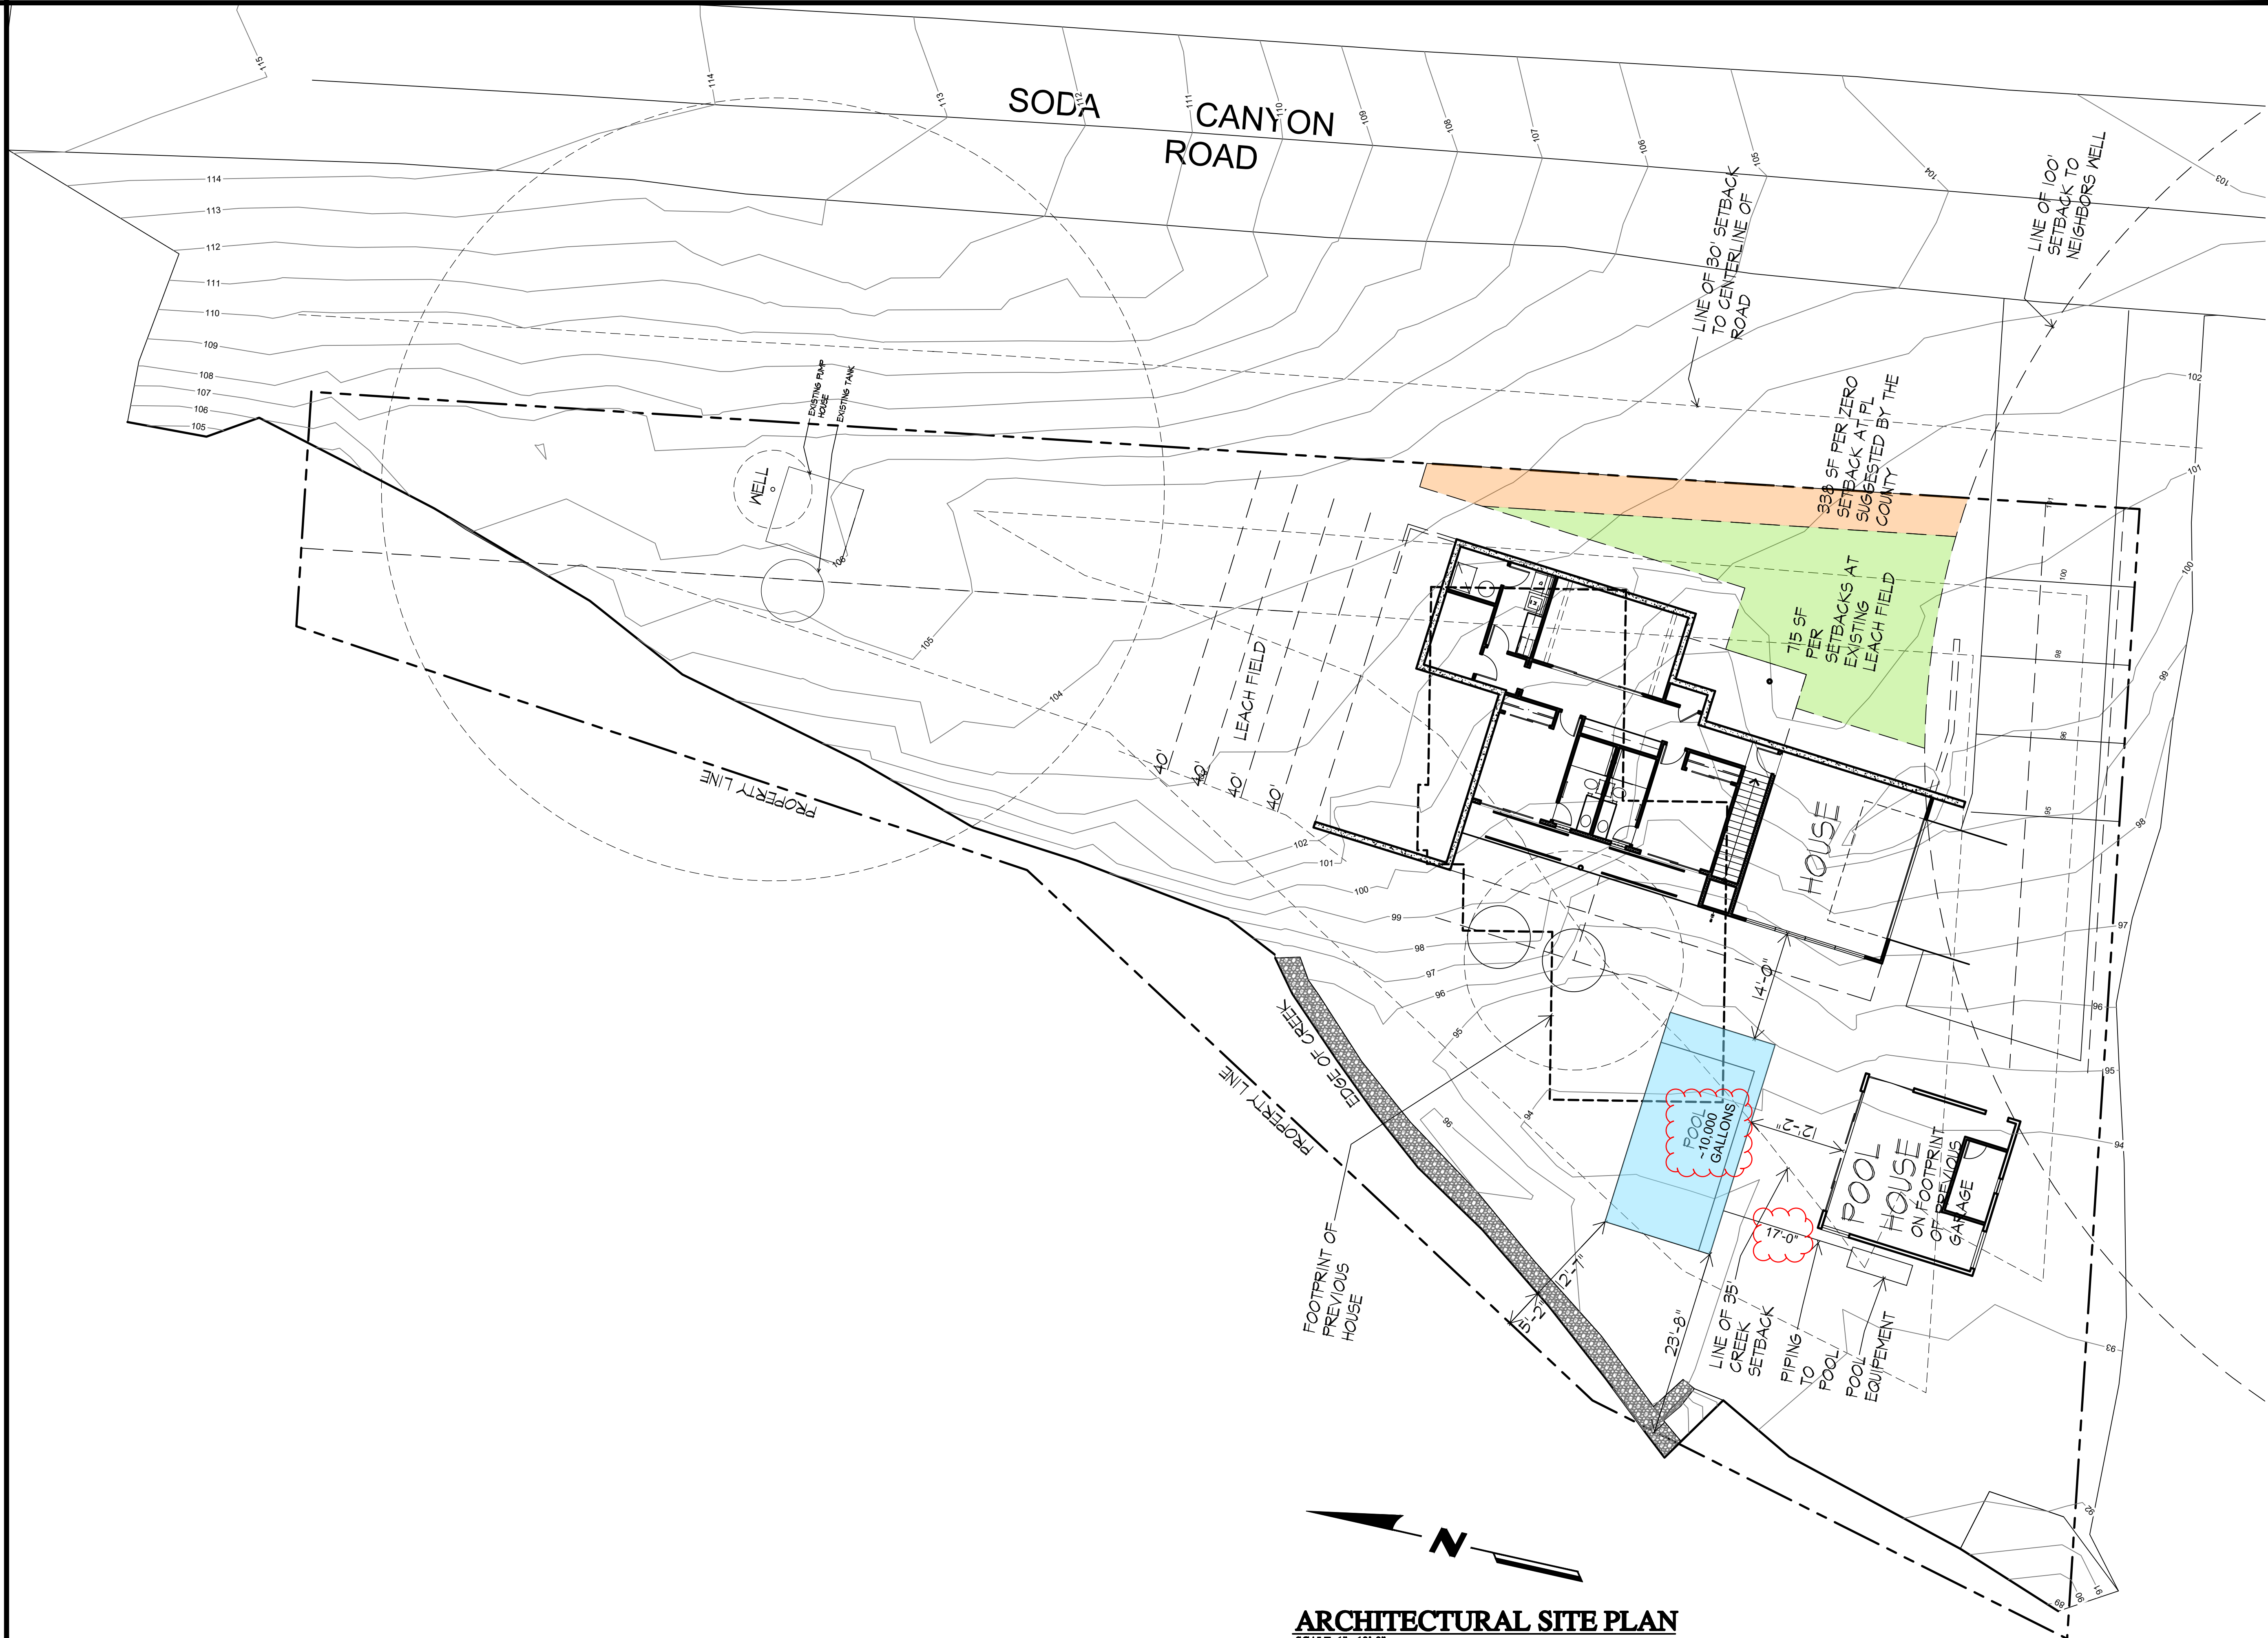

ARCHITECTURAL SITE PLAN
SCALE: 1" = 10'-0"



3361 Walnut Blvd. Suite 120
Brentwood, CA 94513
925.634.7000
sdgarchitectsinc.com

SODA CANYON
1229 SODA CANYON RD.
NAPA, CA 94558
A.P.N. 039-130-005

**COUNTY
APPROVAL**

POOL SITE PLAN

REVISIONS

△ DELTA | PLAN CHECK: 04-04-22

SET DATE 01/04/2024

ISSUE DATE 01/11/2022

SCALE AS NOTED

DRAWN

JOB

100.151

PM

QC

OL

JFO

GENERAL - SHEET

AS2